SHEET'S INDEX
1
33
SANBORN MAP COMPANY
POPULATION
3,395
EPHRATA
DEPARTMENT, SEE REPORT.
EPHRATA
Including SOAP LAKE
GRANT COUNTY
WASHINGTON
JUNE, 1922
NEW YORK
FOR WATER FACILITIES AND FIRE DEPARTMENT, SEE REPORT.
THIS MAP IS CORRECTED TO JUNE, 1944
THIS MAP WAS PRODUCED IN THE PRODUCTION PLANT OF THE SANBORN MAP COMPANY AT LOS ANGELES, CALIFORNIA, AND NEW YORK

CORRECTION RECORD

REVN NO.	DATE OF CORRECTION	ATTACHED BY	DATE ATTACHED
3	8/44	Dap	12-2-46

PASTE OVER ORIGINAL INDEX

EPHRATA, WASH.

NEW INDEX, AUGUST, 1944

STREETS

	SHEET
A Street N. E.	1
" N. W.	1
" S. E.	1
" S. W.	1
Adams, see Second Ave. S. W.	
B Road, west of Street N. W.	4
B Street N. E.	1
" N. W.	1
" S. E.	1
" S. W.	1
C Street N. W.	1
" S. W.	1
Cottage, at Soap Lake	6
Coulee, at Soap Lake	6
Country Road, at Soap Lake	6
Cyrus Ave., see Third Ave. S. W.	
D Alley	4
D Street N. W.	1
" S. W.	1
Division Ave., E.	1
" W.	1
Douglas, see A Street N. E. or S. E.	
E Street N. W.	1
Elm, at Soap Lake	6
Evergreen Road, at Soap Lake	6
F Street N. W.	1
Fifth Ave. N. W.	1
" St., see E Street N. W.	
First Ave. N. E.	1
" N. W.	1
" S. W.	1
Fourth Ave. N. W.	1
" St., see B Street N. W.	
Front, see A Street N. W.	
" S. W.	1
Garfield, see B Street N. E.	
Grand, see Fourth Ave. N. W.	4
Hamill Ave., see Third Ave. N. W.	
Harrison Ave., see Sixth Ave. N. W.	
Indiana, at Soap Lake	6
Jefferson Ave., see First Ave. N. E.	
" N. W.	1
Lake, at Soap Lake	6
" Ave., at Soap Lake, see Main	
Lincoln Ave., at Soap Lake, see Main	
Lincoln Ave., see Second Ave. N. E.	
" N. W.	1
Locust, at Soap Lake	6
McKinley Ave., see Fifth Ave. N. W.	
McMillen Ave., see Third Ave. S. W.	
Main, at Soap Lake	6
Maple, at Soap Lake	6
Meredith, at Soap Lake	6
Pacific Ave., see Division Ave. E.	
" W.	1
Second Ave. N. E.	1
" N. W.	1
" S. W.	1
" St., see B Street N. W.	
Sheam, at Soap Lake	6
Sixth Ave. N. W.	1
" St., see F Street N. W.	
State, at Soap Lake	6
Third Ave. N. W.	1
" S. W.	1
" St., see F Street N. W.	
Washington, at Soap Lake, see State	

SPECIALS

	SHEET
American Legion Hall	4
Bill Hotel	4
Church of the Nazarene, City Hall	4
Community Church, Hall	4
County Court House	4
Drumheller, T. J., Wool and Feed Warehouse	1
Ephrata Grade School, High School, Public Library	4
Farmers Warehouse Co.	1
Fire Department, at Soap Lake	6
Great Northern R. R. Depot,	1
Hotel Morris	4
Ice and Garage	4
Packard Va. L. Inc., Lumber, Public School, at Soap Lake	6
Sehrig, Hy. & Sons, Bathhouse	6
Shell Oil Co.	4
Soap Lake Garage, Produce & Curio, Sandstone	6
Spindler, Geary Co., Standard Oil Co., Bulk Plant	1
Thirteen Soap Lake Products Co.	6
Union Methodist Church, Hall Co.	4
U. S. H. Recreation Building,	6
Washington State Highway Dept., Water Power Co.	1

* Indicates only one side of Street shown.

PASTE OVER ORIGINAL REPORT

EPHRATA, WASH.

NEW REPORT, April, 1940

PAVING: Street not paved.
GRADES: Level.

WATER FACILITIES

Municipal water system. Water from 12" well, 215' deep, located 11 mile southeast of Town; pumps of above well supplied by 1 Peerless electric turbine pumps, capacity 600 gallons per minute; triplex water lift is 200,000 gallon capacity reservoir with wooden roof, located on hillside about 1/2 mile southeast of P.O. Distribution system: Mains from both well and reservoir flow through a 10" main to main intersection, thence through 8", 6" and 4" mains. Total of 17,465 feet of mains, all of which are laid in 1939 and the remainder of the year to 1915. There are 55 hydrants connected with 100,000 gallon G. S. Ry. Water Tank, which is located in an emergency. 28 standard hydrants, 3 of which have 2 hose connections. Various gate valves in the district GI Bo.

FIRE DEPARTMENT

Organized volunteer. 1 chief and 11 members, none paid. 2 men to be paid for duty when building is completed.

1 Ford Mercury auto truck with 1 centrifugal pump, capacity 500 gallons per minute; 1 triplex booster tank attached to a 55 gallon per minute booster pump, 1,250' 2½" hose, 250' 1½" hose and 150' 2" hose.

Fire alarm by electric siren and bell on roof of Fire Station. Connection with Telephone Exchange and push buttons at Fire Stations.

Fire Limits shown by heavy red line on Key.
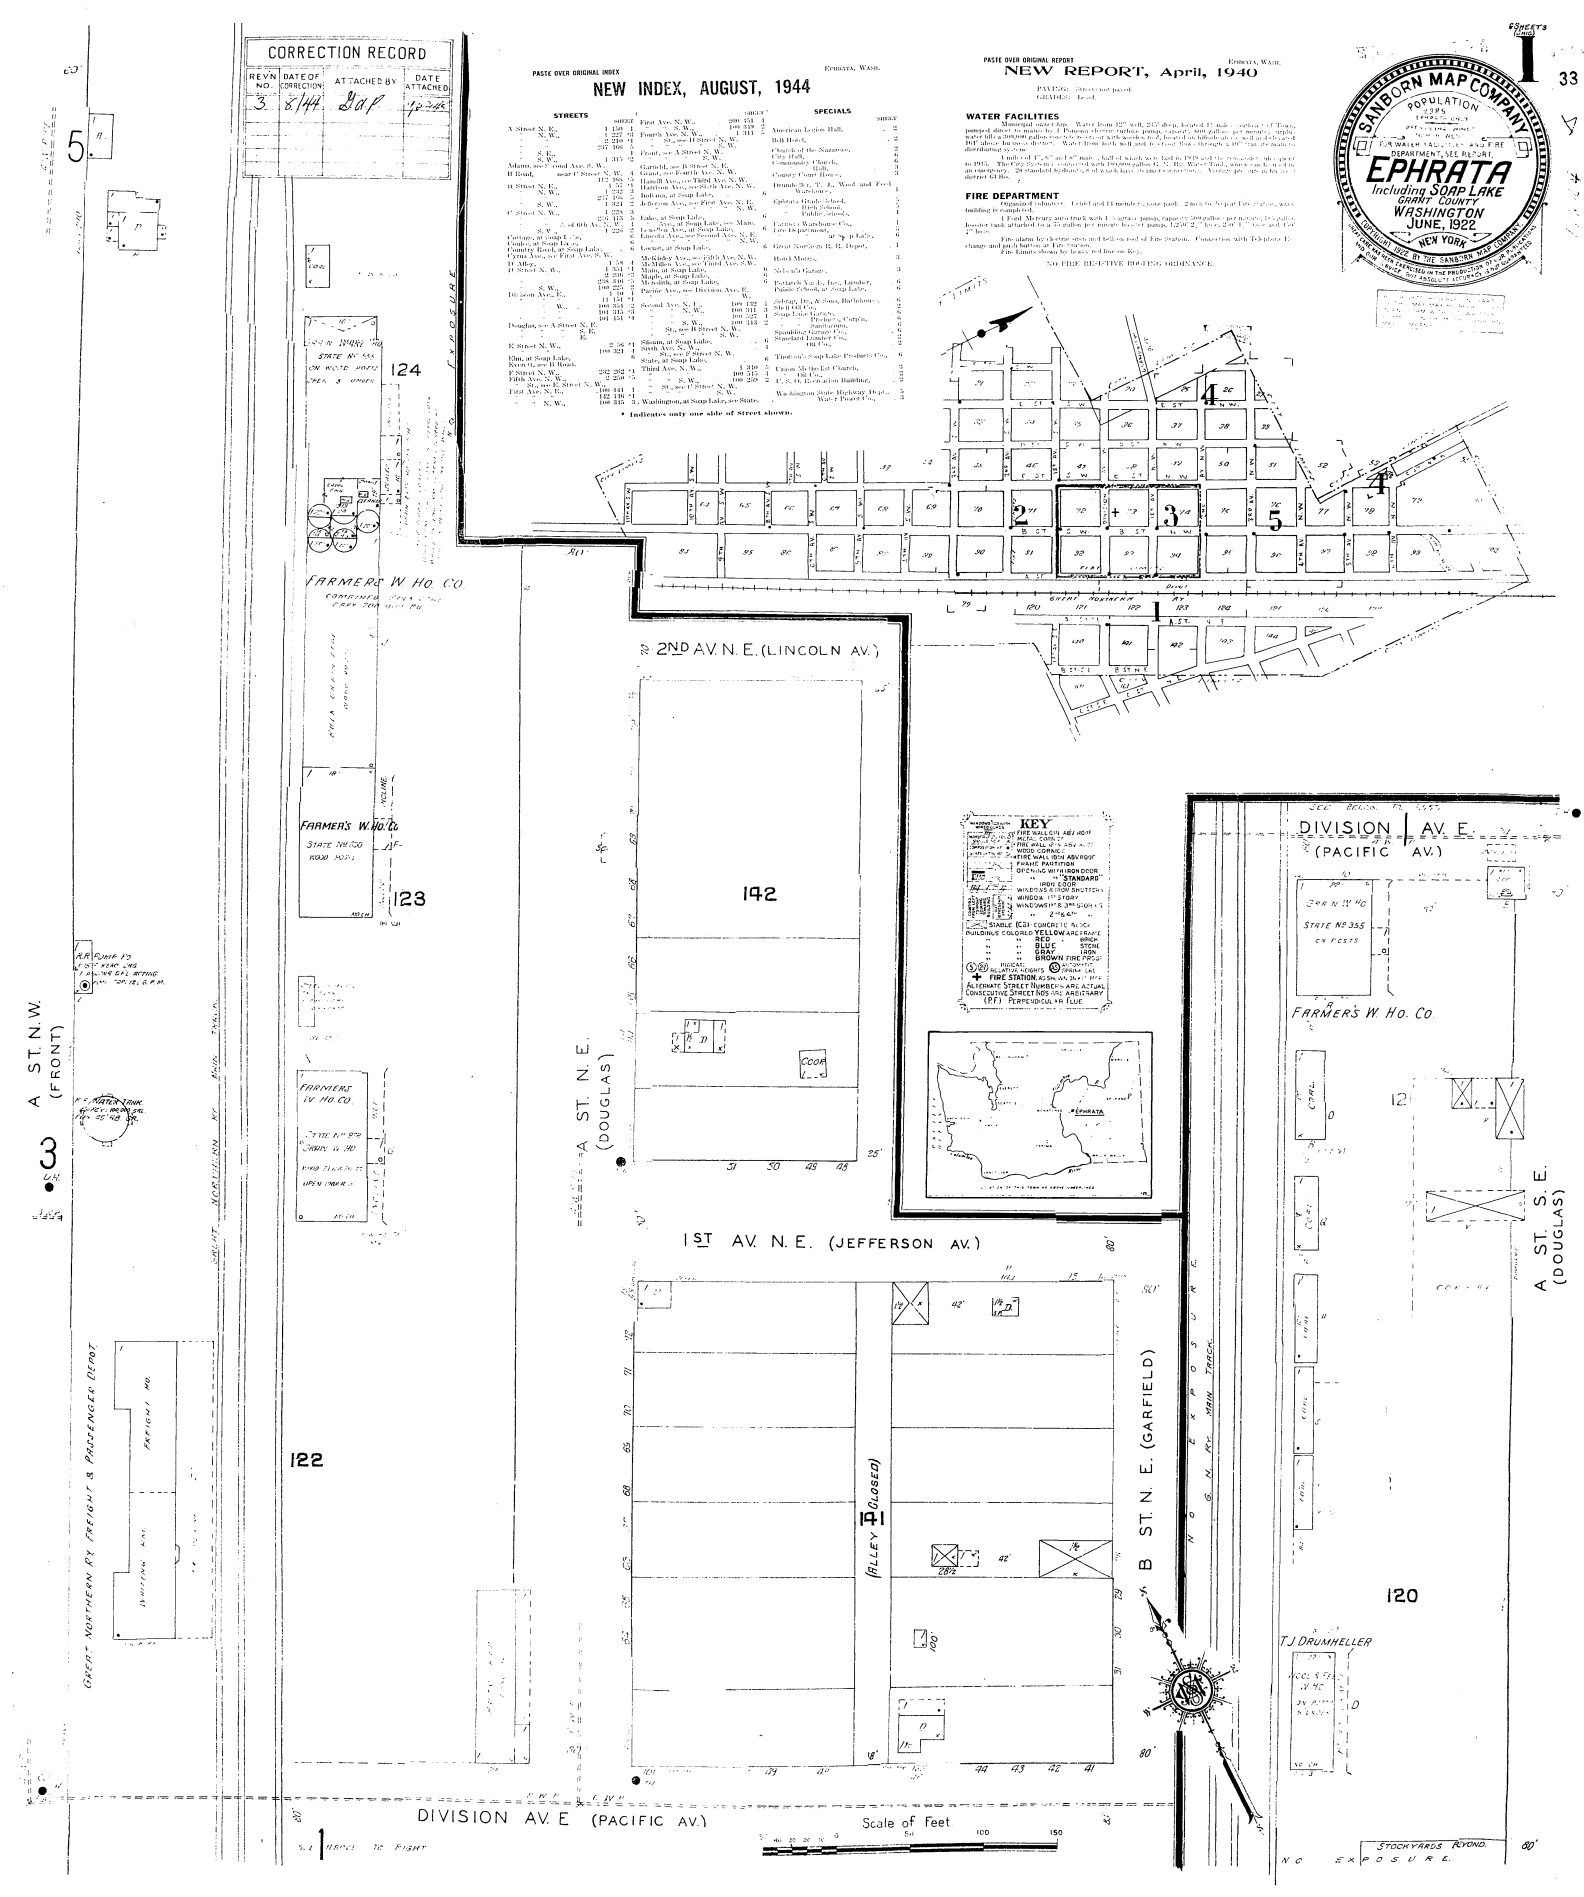
NO FIRE RESTRICTIVE ROOFING ORDINANCE.