1- 500,000 GAL. CONC. RESERVOIRS

CORRECTION RECORD			
REVN NO.	DATE OF CORRECTION	ATTACHED BY	DATE ATTACHED
3	3/45	Gap	4/27/46

PASTE OVER ORIGINAL REPORT

WATERVILLE, WASH.

NEW REPORT, March, 1942

PAVING:—One mile paved streets.

GRADES:—Level.

WATER FACILITIES

Municipal ownership. Gravity and direct systems. Water pumped from a dug well 25' deep by a Pomona 120 gallon per minute pump direct into mains. One 6" drilled well 750' deep. Pomona deep well turbine pump, capacity 150 gallons per minute, located Block 100, Sheet 8, pumps direct into mains. Supply from 13 springs located in Badger Mountains 7 miles northwest of Town via gravity through a 6" steel main to a 150,000 gallon steel tank, located 1 mile south and elevated 127' above Post Office. Supply from 2 springs 3 miles southeast of Town via gravity main to Town. Two concrete reservoirs, capacity 200,000 gallons each, located one mile south of Town and elevated 127' above Post Office. Thence through a 10" transite pipe to Town. 60 lbs gravity pressure to 34 double hydrants.

About 5 miles of 8", 6" and 4" Mathewson steel mains laid in 1917 and subsequently. Daily consumption about 200,000 gallons. Minimum flow from springs 150 gallons per minute.

FIRE DEPARTMENT

Organized. Volunteer. 1 chief, partly paid, and 19 men.

1 Chevrolet truck, capacity 500 gallons per minute, 1,000' 2½" hose, 600' 1½" hose, one 200 gallon booster tank, 200' 1" hose, 2 pump cans, one 2½ gallon chemical extinguisher and one 36' ladder.

DOUGLAS COUNTY FIRE PROTECTION DISTRICT NO. 1—1 Ford V 8 truck, 200 gallons per minute, 500' 2½" hose, 300' 1½" hose, one 1,000 gallon booster tank, 150' 1" hose, one 2½ gallon CO₂ tank, 1 pyrene, one 2½ gallon soda and acid, two 5 gallon pump cans, and 42' of ladders, located Block 102, Sheet 6. Will answer city calls.

FIRE ALARM:—Electric siren on roof of City Hall.

FIRE LIMITS:—Shown by heavy red line on Key Map.

NO FIRE RESISTIVE ROOFING ORDINANCE.

8-SHEETS (CHIC.) 1 33

SANBORN MAP COMPANY

POPULATION 939

PREVAILING WINDS, NORTHWEST

FOR WATER FACILITIES AND FIRE DEPARTMENT, SEE REPORT.

WATERVILLE

DOUGLAS COUNTY WASHINGTON

JULY, 1922

NEW YORK

COPYRIGHT 1922 BY THE SANBORN MAP COMPANY. ENTERED AT STATIONERS' HALL, LONDON. THIS MAP IS ISSUED IN THE EXPECTATION THAT IT WILL BE USED AS A WHOLE, AND THAT THE USER WILL EXERCISE DUE CARE TO PRESERVE ABSOLUTE ACCURACY. THE COMPANY IS NOT RESPONSIBLE FOR ERRORS OR OMISSIONS.

MAP INDEX

KEY

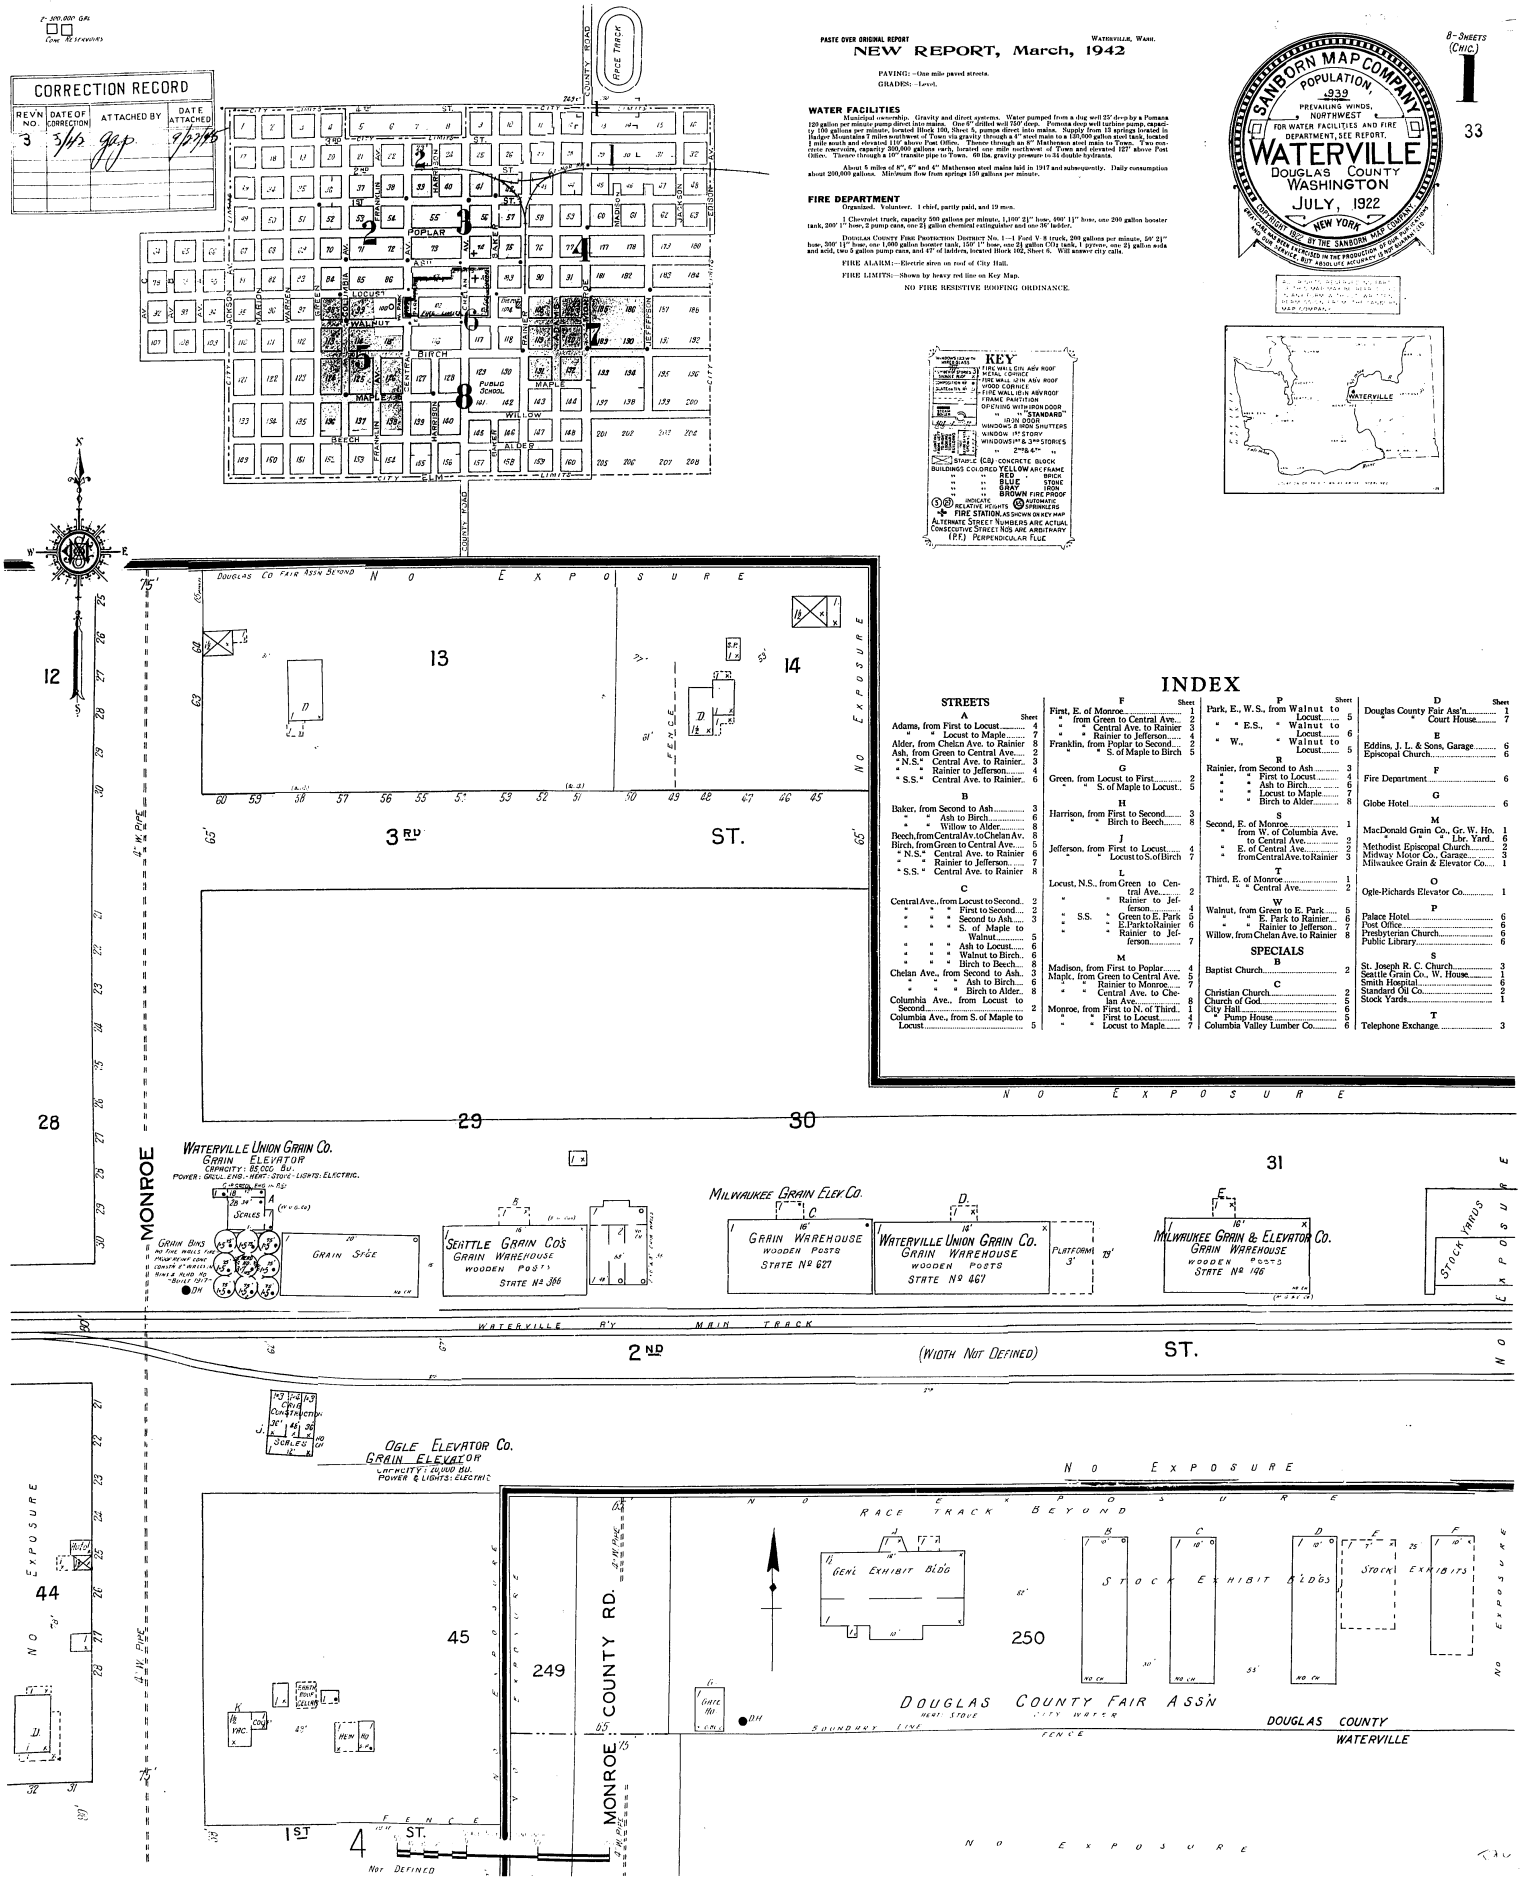

INDEX

STREETS

A

Adams, from First to Locust ..... Sheet 4
" " Locust to Maple 7
Alder, from Chelan Ave. to Rainier 8
Ash, from Green to Central Ave. ... 2
" N.S." Central Ave. to Rainier.. 3
" " Rainier to Jefferson 4
" S.S." Central Ave. to Rainier.. 6

B

Baker, from Second to Ash 3
" " Ash to Birch 6
" " Willow to Alder 8
Beech, from Central Ave. to Chelan Av. 8
Birch, from Green to Central Ave. ... 5
" N.S." Central Ave. to Rainier 6
" " Rainier to Jefferson.. 7
" S.S. " Central Ave. to Rainier 8

C

Central Ave., from Locust to Second.. 2
" " " First to Second 2
" " " Second to Ash 3
" " " S. of Maple to Walnut 5
" " " Ash to Locust 6
" " " Walnut to Birch.. 6
" " " Birch to Beech... 8
Chelan Ave., from Second to Ash.. 3
" " " Ash to Birch... 6
" " " Birch to Alder.. 8
Columbia Ave., from Locust to Second 2
Columbia Ave., from S. of Maple to Locust 5

F

First, E. of Monroe 1
" from Green to Central Ave.. 2
" " Central Ave. to Rainier 3
" " Rainier to Jefferson 4
Franklin, from Poplar to Second.... 2
" " S. of Maple to Birch 5

G

Green, from Locust to First 2
" " S. of Maple to Locust.. 5

H

Harrison, from First to Second 3
" " Birch to Beech 8

J

Jefferson, from First to Locust 4
" " Locust to S. of Birch 7

L

Locust, N.S., from Green to Central Ave 2
" " Rainier to Jefferson 4
" S.S. " Green to E. Park 6
" " E. Park to Rainier 6
" " Rainier to Jefferson 7

M

Madison, from First to Poplar 4
Maple, from Green to Central Ave. 5
" " Rainier to Monroe.... 7
" " Central Ave. to Chelan Ave 8
Monroe, from First to N. of Third.. 1
" First to Locust 4
" " Locust to Maple 7

P

Park, E., W.S., from Walnut to Locust 5
" " E.S., " Walnut to Locust 6
" W., " Walnut to Locust 5

R

Rainier, from Second to Ash 3
" " First to Locust 4
" " Ash to Birch 6
" " Locust to Maple 7
" " Birch to Alder 8

S

Second, E. of Monroe 1
" from W. of Columbia Ave. to Central Ave. 2
" " E. of Central Ave. 2
" from Central Ave. to Rainier 3

T

Third, E. of Monroe 1
" " Central Ave 2

W

Walnut, from Green to E. Park 5
" " E. Park to Rainier.. 6
" " Rainier to Jefferson.. 7
Willow, from Chelan Ave. to Rainier 8

SPECIALS

B

Baptist Church 2

C

Christian Church 2
Church of God 5
City Hall 6
" Pump House 5
Columbia Valley Lumber Co 6

D

Douglas County Fair Ass'n 1
" " Court House 7

E

Eddins, J. L. & Sons, Garage 6
Episcopal Church 6

F

Fire Department 6

G

Globe Hotel 6

M

MacDonald Grain Co., Gr. W. Ho. 1
" " Lbr. Yard.. 6
Methodist Episcopal Church 2
Midway Motor Co., Garage 3
Milwaukee Grain & Elevator Co.... 1

O

Ogle-Richards Elevator Co 1

P

Palace Hotel 6
Post Office 6
Presbyterian Church 6
Public Library 6

S

St. Joseph R. C. Church 3
Seattle Grain Co., W. House 1
Smith Hospital 6
Standard Oil Co 2
Stock Yards 1

T

Telephone Exchange 3